


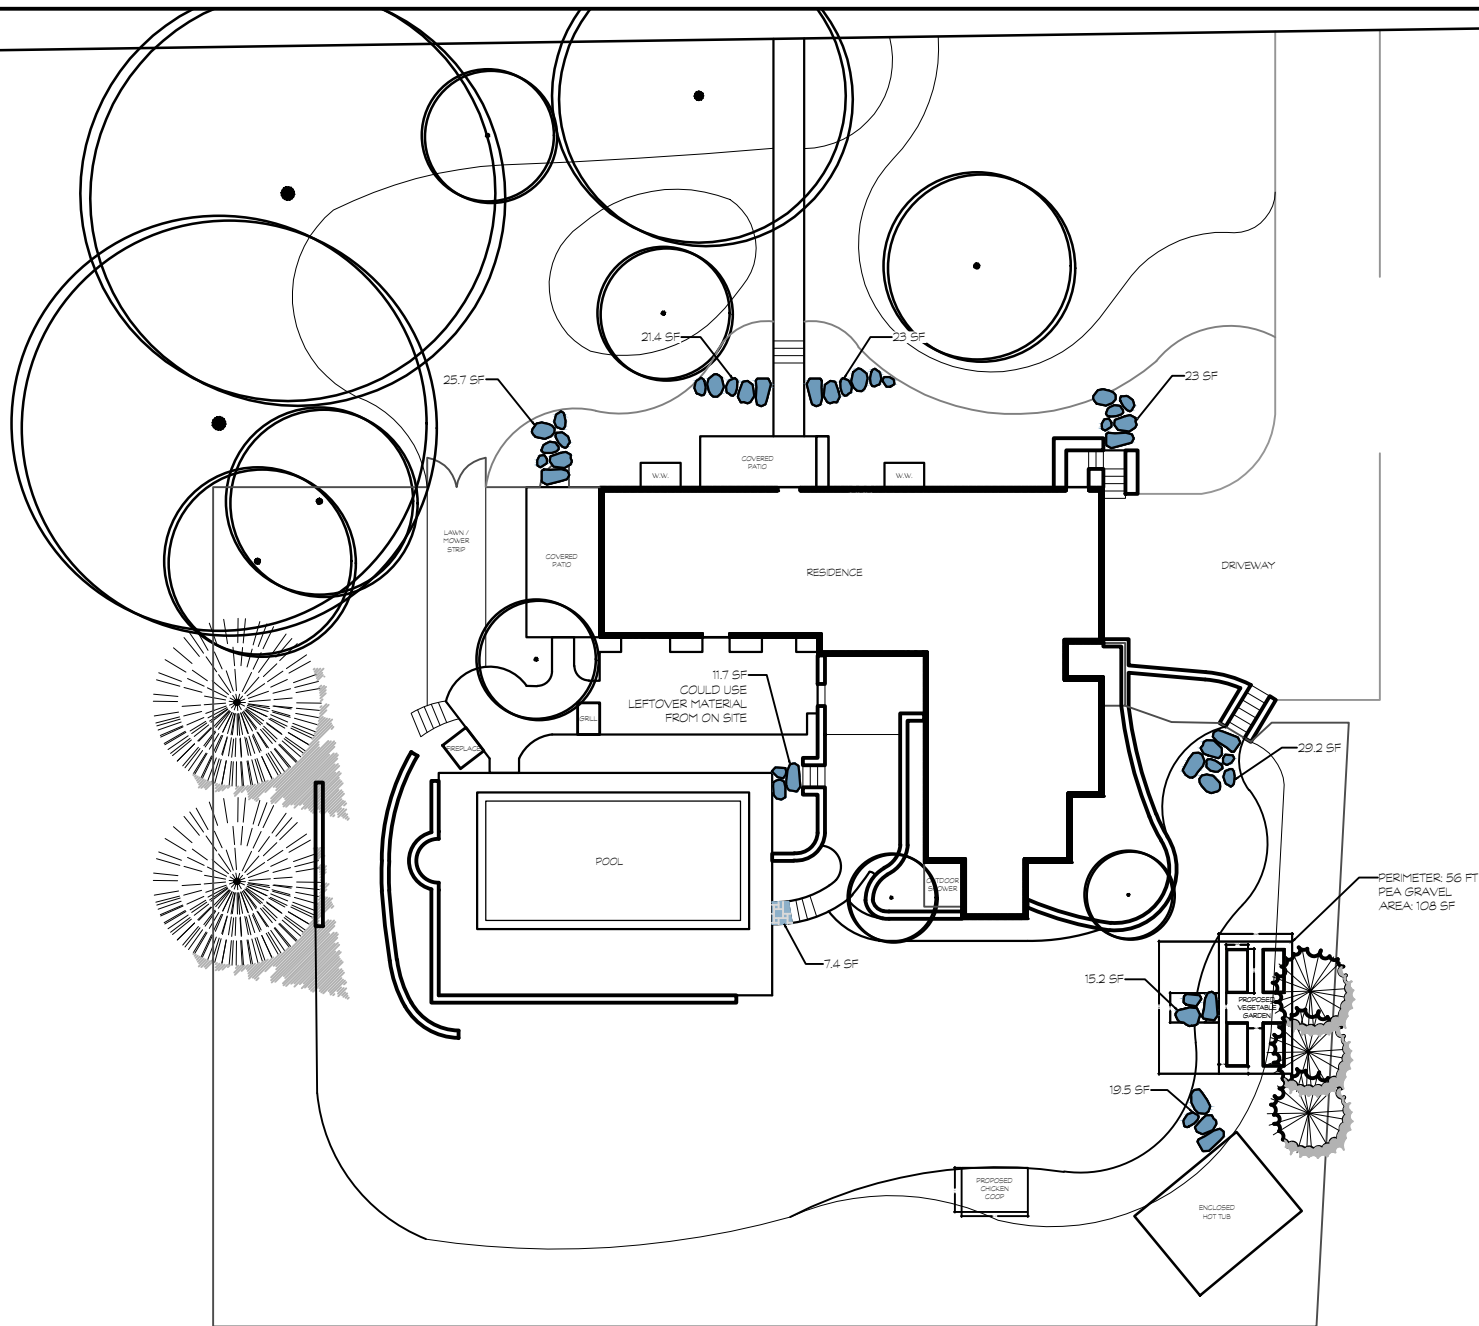

NOTES

1. Plan and site information provided by Terren Landscapes.
2. Terren Landscapes accepts no responsibility for the accuracy of the information provided by the client and/or survey. These landscape plans have been developed for the use of Terren Landscapes using site plans and information provided by others. If the Contractor finds the site differs from the plan, the Contractor shall alert the client prior to construction of any part of the design affected by the perceived difference and notify the surveyor.
3. In the event that no site plan is provided or commissioned, site measurements will be taken by Terren Landscapes. The measurements taken are not an engineering survey and therefore may not contain the same detailed information. Any adequate information shown is approximate and should be verified on site.
4. The Contractor shall verify the location of all utilities prior to commencement of any construction activities by requesting a PA One Call and proceeding according to the mark out.
5. The Contractor shall obtain all permits for construction activities as required by the local municipality, state and federal regulations. All permits shall be obtained prior to commencement of the work associated with the permit. The Contractor shall abide by all rules and regulations set forth by the permits required for construction activities.
6. The Contractor shall at all times keep the construction site in an orderly condition, store materials in a pre-determined location, minimize site disturbance, and remove all debris and excess material from the site.
7. The Contractor shall install and maintain erosion control measures as required or necessary.
8. The Contractor shall provide Certificates of Insurance to the owner prior to commencement of work. The Contractor shall provide Certificates of Insurance of any subcontractor prior to their commencement of work.

REVISIONS

terren
LANDSCAPES

900 Matsfonford Road
Conshohocken, PA 19428

terrenlandscapes.com
(610) 284-4400

GRAHAM RESIDENCE

311 Millbank Road
Bryn Mawr, PA 19010

CLIENT APPROVAL

I approve these drawings and understand that any further design work may involve additional fees.

NAME:

SIGNATURE:

DATE:

HARDSCAPE PLAN

SCALE: 1/4" = 1'-0"
DATE: _____
DRAWN BY: _____

L-2